



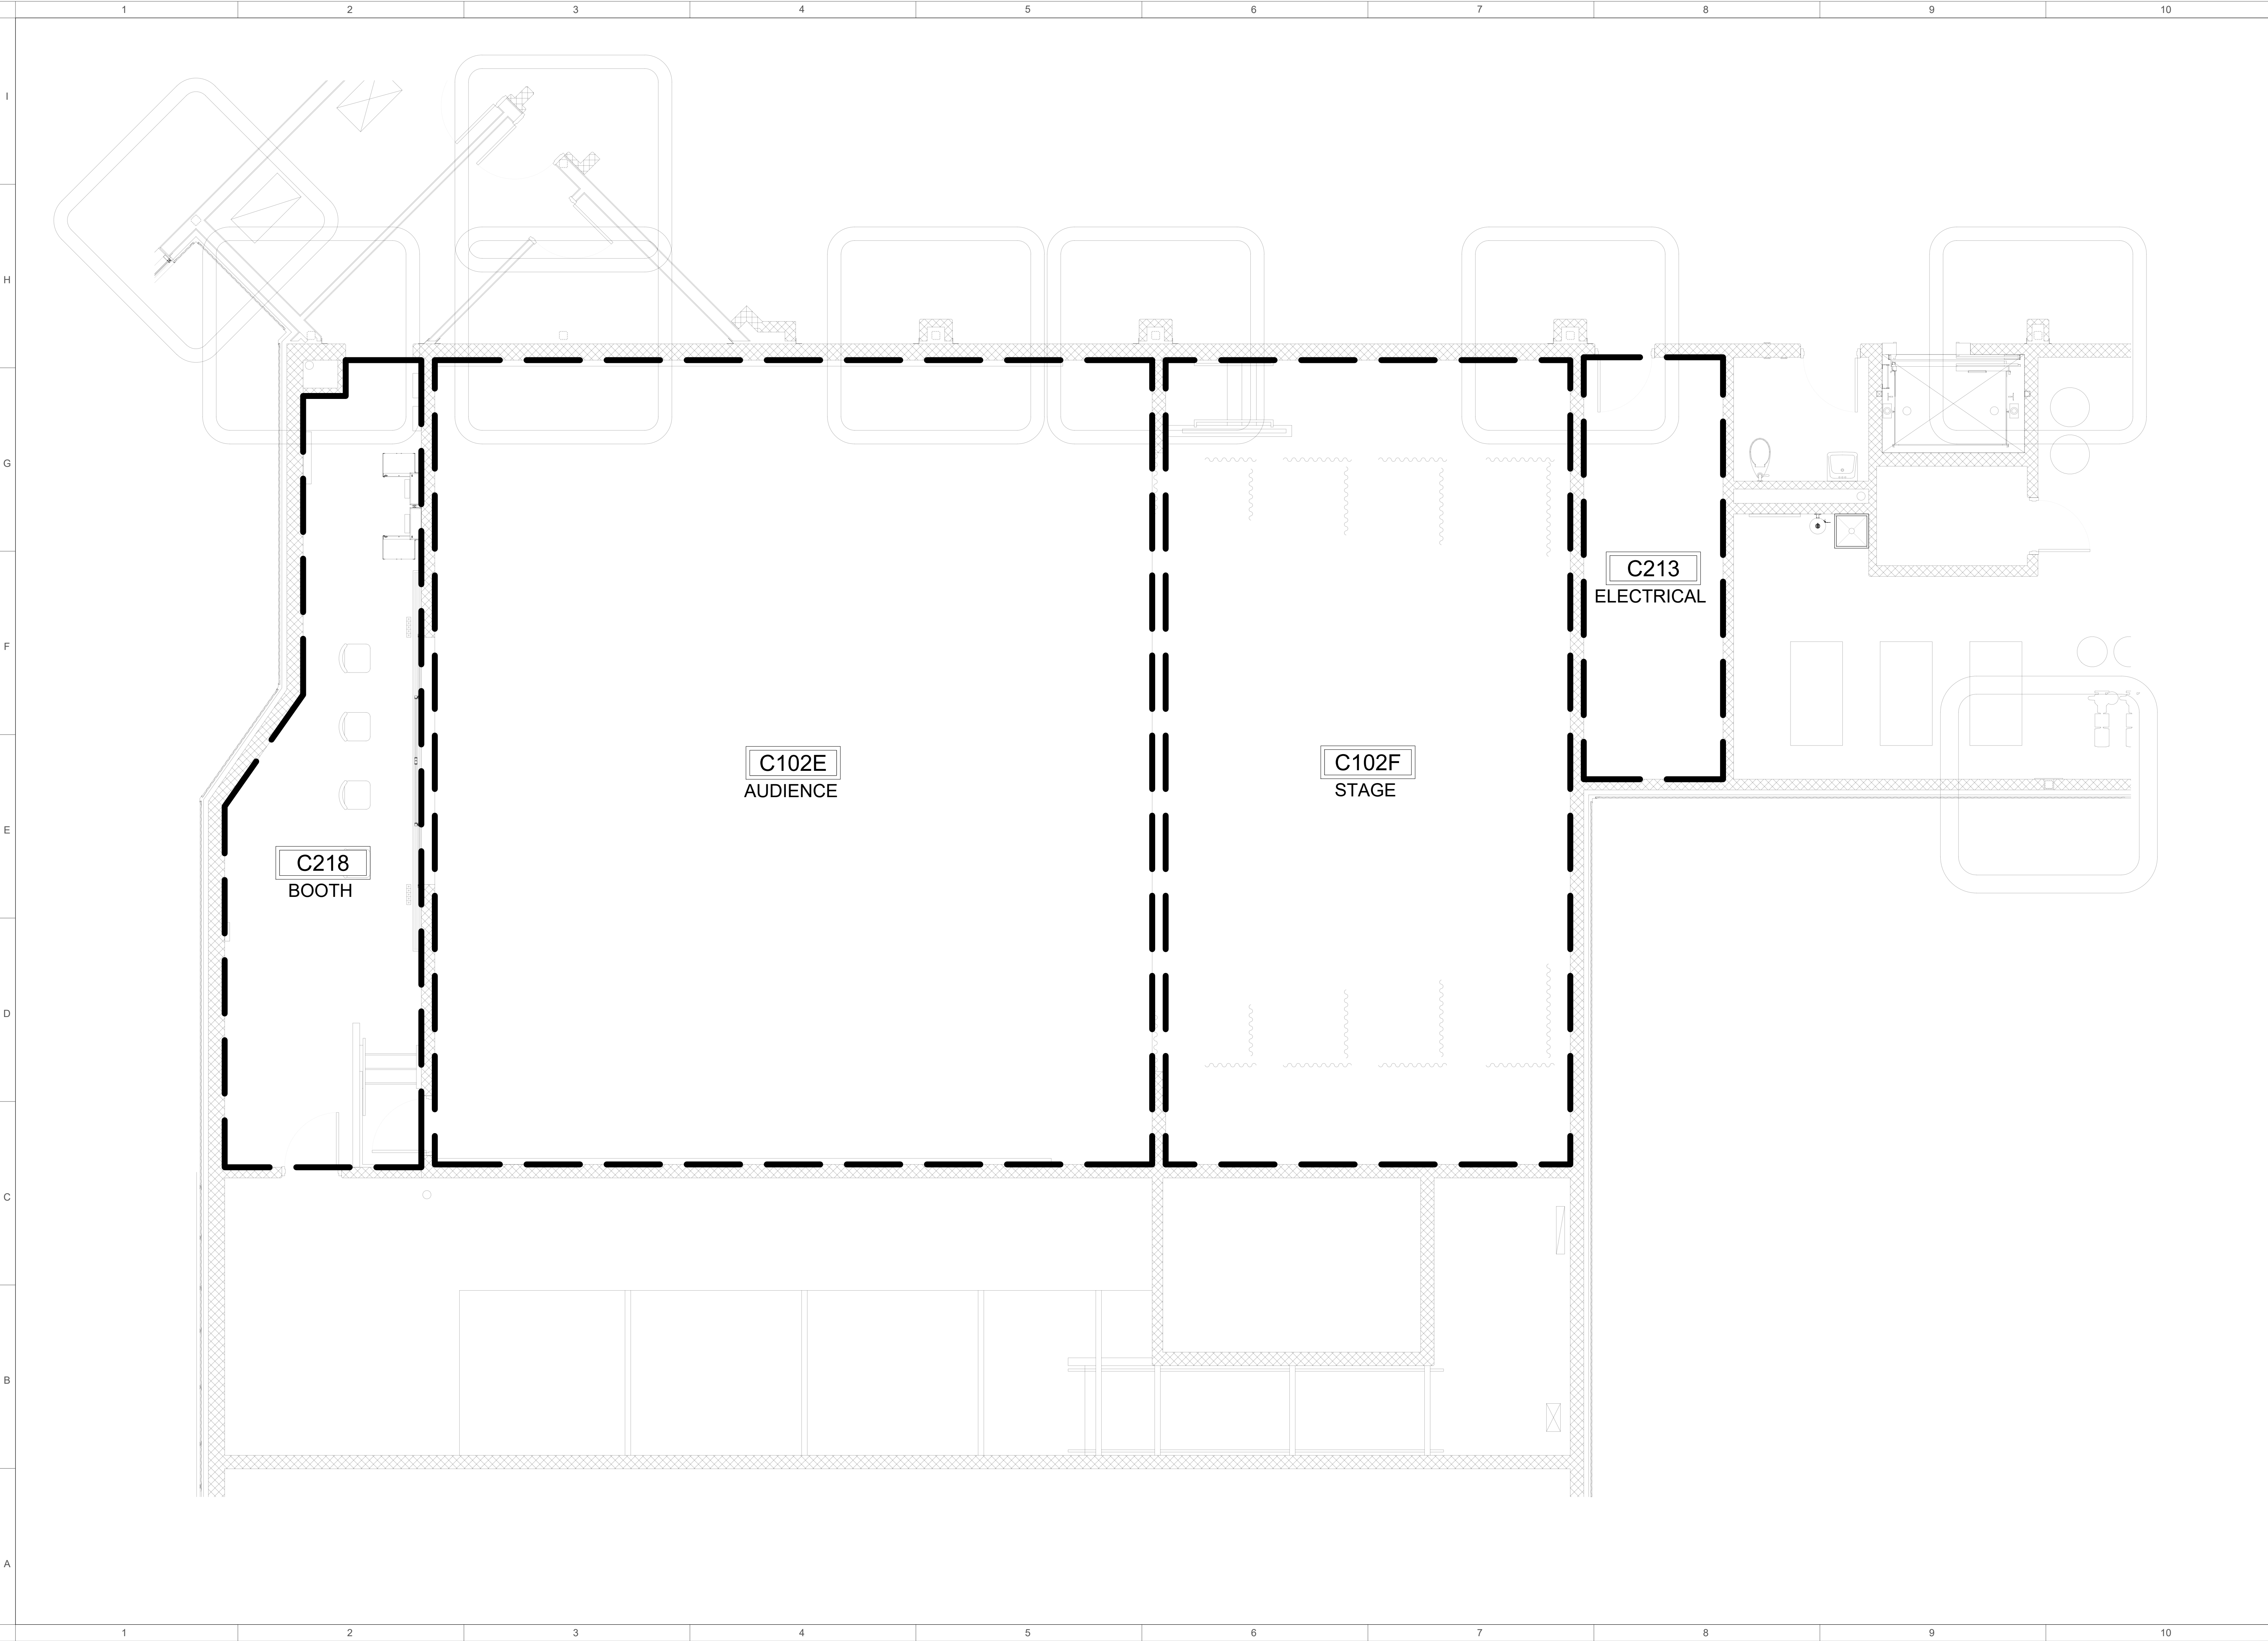

CURRENT LOCATION

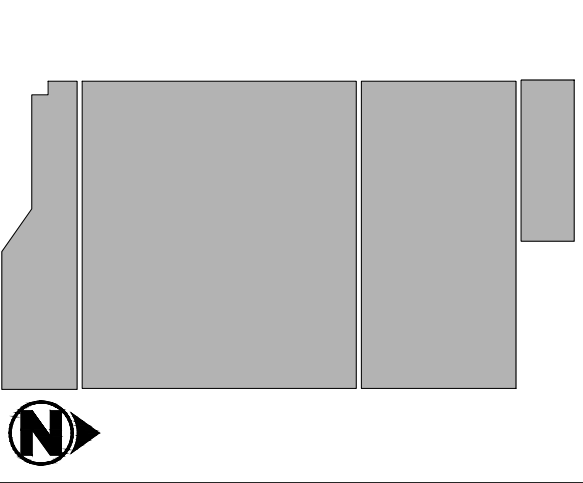

V3	AS-BUILT	JUN/21/2024
V2	REVISED UPDATES	NOV/17/2023
V1	APPROVAL	OCT/28/2023
NO.	REVISION HISTORY	DATE

THIS DRAWING AND ALL RELATED DOCUMENTATION INCORPORATE PROPRIETARY RIGHTS OF FIELD SERVICE, CA INC. & CHRISTIE LITES SALES LTD. ANY PARTY ACCEPTING THIS DOCUMENT DOES SO IN CONFIDENCE AND AGREES THAT IT SHALL NOT BE DUPLICATED IN WHOLE OR IN PART, NOR DISCLOSED TO OTHERS WITHOUT PRIOR WRITTEN CONSENT BY AN AUTHORIZED REPRESENTATIVE OF FIELD SERVICE, CA INC. OR CHRISTIE LITES SALES LTD.

PROJECT
ÉCOLE SECONDAIRE
FRONTENAC KINGSTON

PROJECT ADDRESS
1381 DEMERS AVE.
KINGSTON ON,
K7M 3X9

TITLE
SECOND FLOOR
HIGHLIGHTED
FLOOR PLAN

CHRISTIE LITES SALES

1545 Britannia RD E
Unit 11&12
Mississauga, ON
Canada, L4W 3C6
Phone:416.644.1010
www.christielitesales.com



65 Denzil Doyle Ct
Unit 103
Kanata, ON K2M 2G8
Canada
Phone:416.887.4796
Email:support@fieldservice.ca

CREATED:June 13, 2024 10:12:31 AM		
PLOTTED:June 25, 2024 10:19:09 AM		
DRAWN BY IB	LAST SAVED BY IANBARBER	LAST SAVED ON Jun/25/2024 9:30 AM
SCALE NTS	DRAWING NUMBER	
JOB 23-1768	AV-1200	